


LEGEND

- (FH) FIRE HYDRANT/(DFH) DUCKFOOT
- × (VS) STOP VALVE
- ✕ (VA) SCOUR ASSEMBLY
- (TB) TAPPING BAND
- × (WM) WATER METER (SEQ 20φ)
- ┌ END CAP
- └ TEE
- ^ (RE) REDUCER
- BEND
- DICL WATER MAIN CROSSING
- CONDUIT/CROSSING
- EXISTING WATER


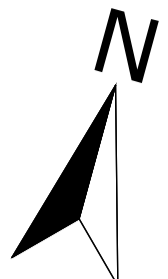


NOTES

- ALL WATER RETICULATION PIPES ARE φ180 & φ125 PE-100 PN16 U.N.O.
- ALL WATER SERVICE CROSSING PIPES ARE φ100 PVC-M PN16 U.N.O.
- ALL FIRE HYDRANTS ARE φ100 SPRING U.N.O.

REGISTERED SURVEYOR'S CERTIFICATION
 LandPartners Pty Ltd
 hereby certify that the vertical and horizontal locations and dimensions shown on this plan are a true and correct record and were located by survey.
R. G. Andrew Authorised Delegate
 LandPartners Pty Ltd, Reg. Surveyor No. S4118 Date: 3/04/2024

ENGINEER'S CERTIFICATION
 I, _____, hereby certify that:
 1. The information contained in this drawing / document is in compliance with approved drawings and design.
 2. The new water and sewerage works defined by this drawing have been designed and constructed in accordance with the SEQ Code.
 3. This represents an accurate record of as-constructed works.
 4. I accept responsibility for the information contained in this drawing / document.
 RPEQ (signature) RPEQ No. _____ Date: _____

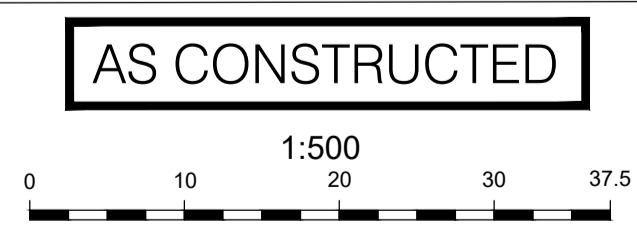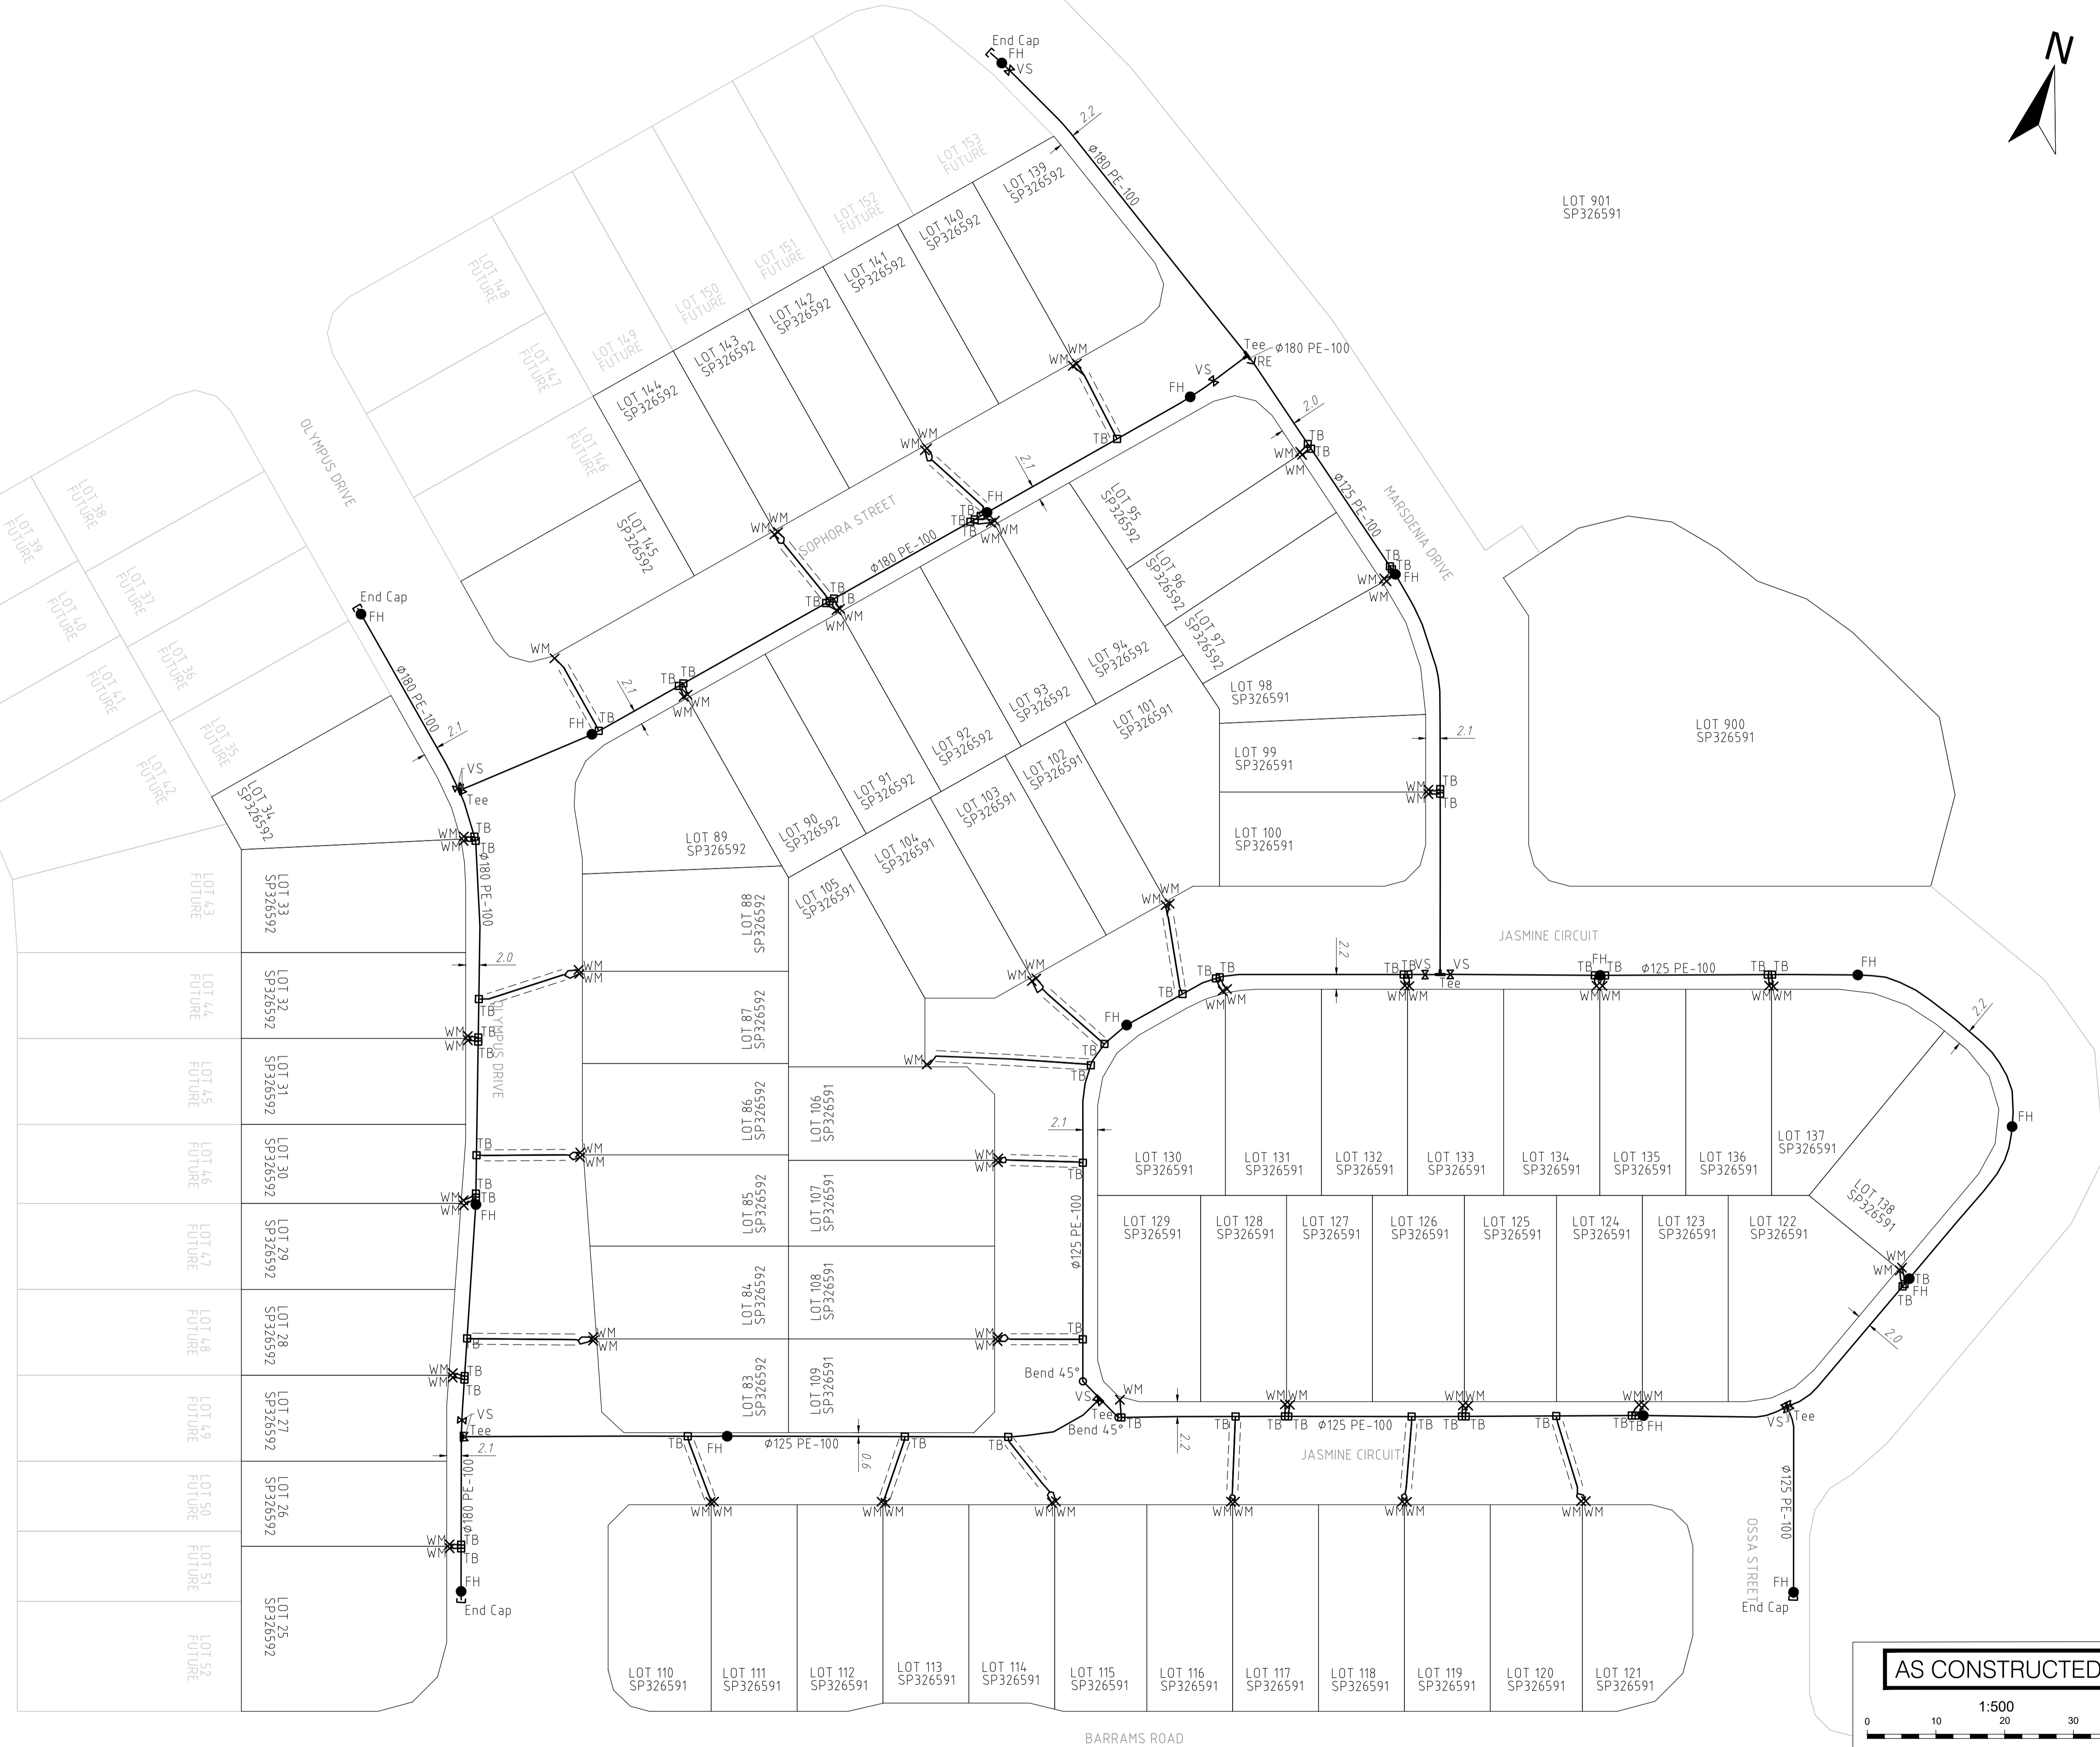

AS CONSTRUCTED

A1

INDEX	DATE	INITIALS	REVISIONS	DRAWN	CHECKED	PASSED
1	2/04/2024		INITIAL ISSUE	MJK	RA	RA

INITIALS	DATE
DRAWN MJK	28/03/2024
CHECKED RA	2/04/2024
PASSED RA	2/04/2024

LANDPARTNERS
 surveyors and planners
 Brisbane Office
 Level 1
 18 Little Cribb Street
 Milton QLD 4064
 PO Box 1399
 Milton
 QLD 4064
 P (07) 3842 1000
 F (07) 3842 1001
 E info@landpartners.com.au
 W www.landpartners.com.au



Queensland Urban Utilities

MONTVIEW ESTATE STAGE 1 & 1a
 AS CONSTRUCTED WATER
 22-PNT-55808 & 22-PNT-55809

SCALE 1500 @ A1
 SHEET 1 OF 1 SHEETS
 DRAWING NO.
 BRSS7277-AP1-141-1