


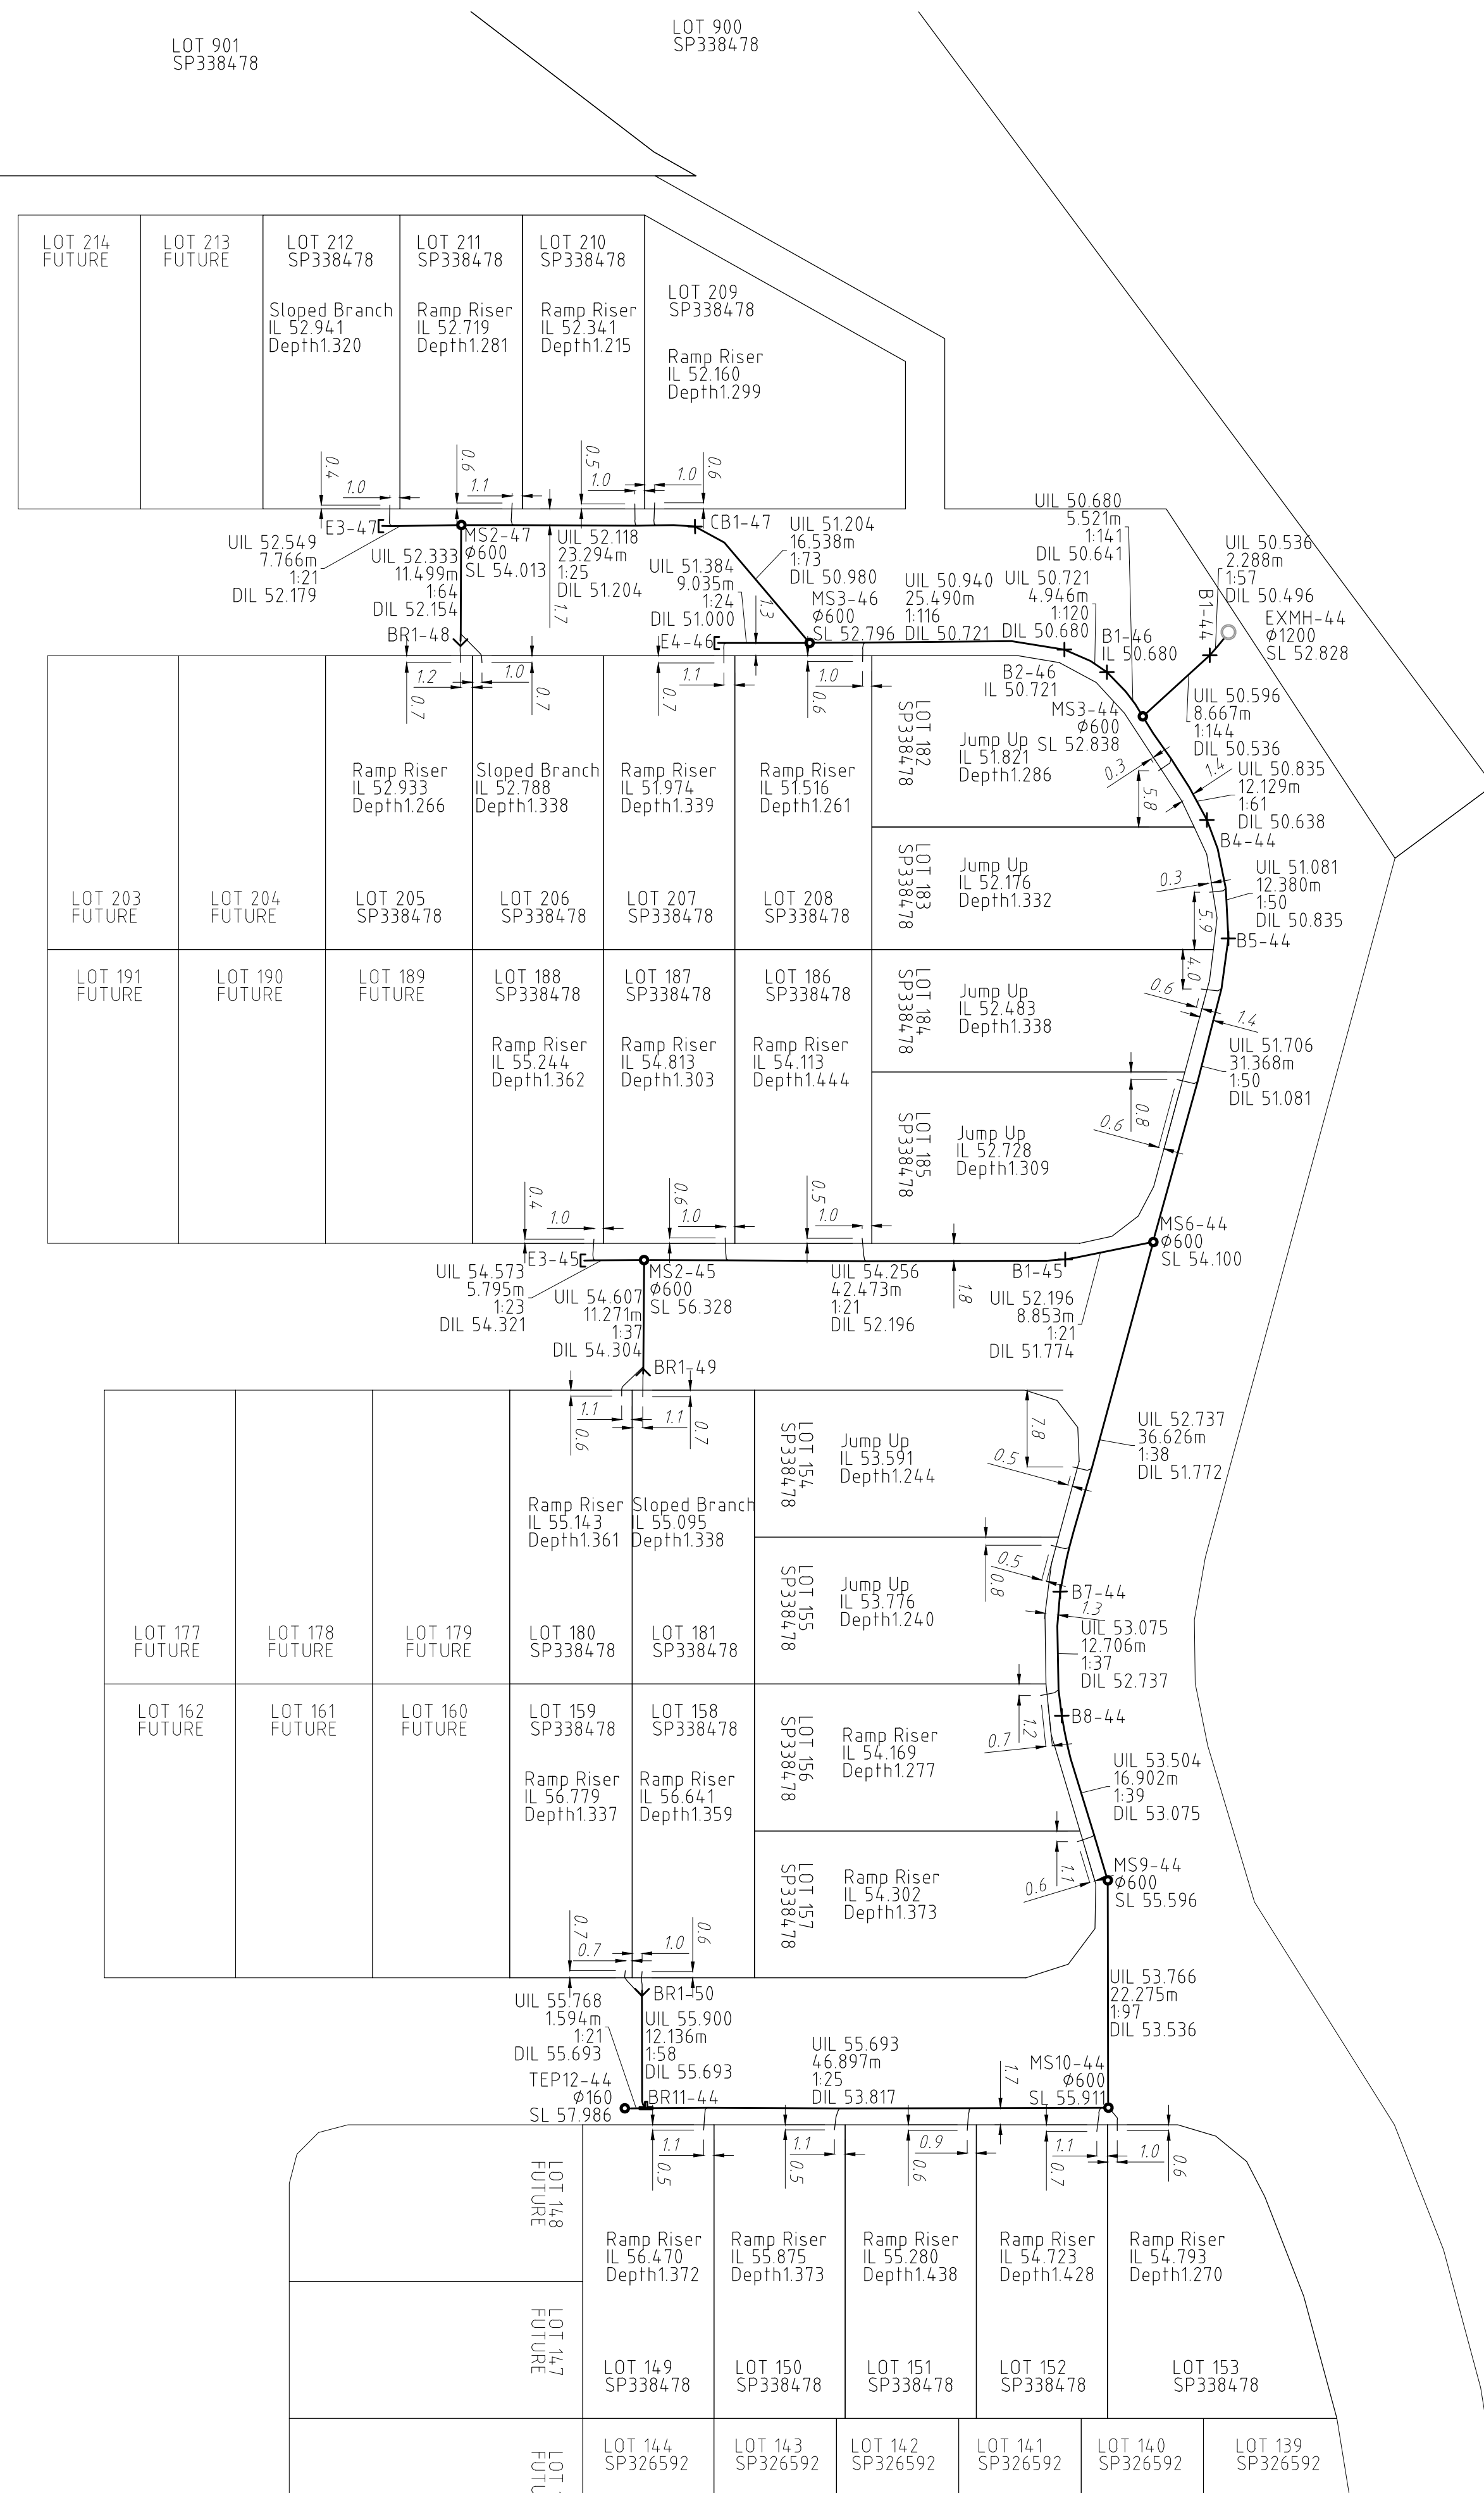

ENGINEER'S CERTIFICATION

I, _____, hereby certify that:

1. The information contained in this drawing / document is in compliance with approved drawings and design.
2. The new water and sewerage works defined by this drawing have been designed and constructed in accordance with the SEQ Code.
3. This represents an accurate record of as-constructed works.
4. I accept responsibility for the information contained in this drawing / document.

RPEQ (signature)

RPEQ No.

Date:

A1						
	1	6/08/2024	INITIAL ISSUE		BB	MJK
INDEX	DATE	REVISIONS		DRAWN	CHECKED	PASSED

DRAWN	BB	6/08/2024
CHECKED	MJK	6/08/2024
PASSED	RA	6/08/2024
	INITIALS	DATE



Queensland Urban Utilities MONTVIEW ESTATE STAGE 2 AS CONSTRUCTED SEWER 22-PNT-55812	SCALE 1500		
	SHEET 1	OF 1	SHEETS
	DRAWING NO.		
	BRSS7277-AP2-43-1		