



NOTES

-ALL SEWER RETICULATION PIPES ARE Ø160 PE SDR21 U.N.O.
-ALL SEWER HOUSE CONNECTION PIPES ARE Ø110 PE SDR21 U.N.O.

REGISTERED CADASTRAL SURVEYOR (OLD) CERTIFICATION

LandPartners Pty Ltd, hereby certify that the vertical and horizontal locations and dimensions shown on this plan are a true and correct record and were located by survey.

R. G. Andrew

Authorised Delegate

LandPartners Pty Ltd

Registered Qld Surveyor Corporation

4118

Rego No.

5/12/2024

Date

ENGINEER'S CERTIFICATION

I,, hereby certify that:

1. The information contained in this drawing / document is in compliance with approved drawings and design.

2. The new water and sewerage works defined by this drawing have been designed and constructed in accordance with the SEQ Code.

3. This represents an accurate record of as-constructed works.

4. I accept responsibility for the information contained in this drawing / document.


RPEQ (signature)

RPEQ No. _____

Date: _____



AS CONSTRUCTED

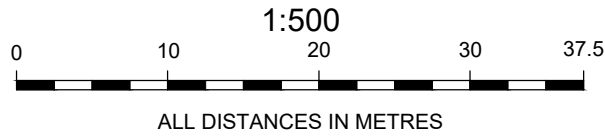

A1

INDEX	DATE	INITIAL ISSUE	REVISIONS	DRAWN	CHECKED	PASSED
1	5/12/2024	INITIAL ISSUE		MJK	RA	RA

DRAWN	MJK	5/12/2024
CHECKED	RA	5/12/2024
PASSED	RA	5/12/2024
INITIALS	DATE	



Brisbane Office
Level 1
19 Little Cabool Street
Milton QLD 4064

PO Box 1399
Milton
QLD 4064

P: (07) 3842 1000
F: (07) 3842 1001
E: info@landpartners.com.au
W: www.landpartners.com.au



Queensland Urban Utilities

MONTVIEW ESTATE STAGE 3
AS-CONSTRUCTED SEWER
22-PNT-55811

SCALE 1:500

SHEET 1 OF 1 SHEETS

DRAWING NO.

BRSS7277-AP3-76-1