

NOTES

- ALL WATER RETICULATION PIPES ARE $\phi 125$ OR $\phi 180$ PE-100 PN16 U.N.O.
- ALL WATER SERVICE CROSSING CONDUIT PIPES ARE $\phi 100$ PVC-M PN12 U.N.O.
- ALL FIRE HYDRANTS ARE $\phi 100$ SPRING U.N.O.

REGISTERED CADASTRAL SURVEYOR (OLD) CERTIFICATION

LandPartners Pty Ltd, hereby certify that the vertical and horizontal locations and dimensions shown on this plan are a true and correct record and were located by survey.

R. G. Anderson 4118 5/12/2024
 Authorised Delegate Rego No. Date
 LandPartners Pty Ltd
 Registered Qld Surveyor Corporation

ENGINEERS CERTIFICATION


I, _____, hereby certify that:

- The information contained in this drawing / document is in compliance with approved drawings and design.
- The new water and sewerage works defined by this drawing have been designed and constructed in accordance with the SEQ Code.
- This represents an accurate record of as-constructed works.
- I accept responsibility for the information contained in this drawing / document.

RPEQ (signature) RPEQ No. Date:



AS CONSTRUCTED

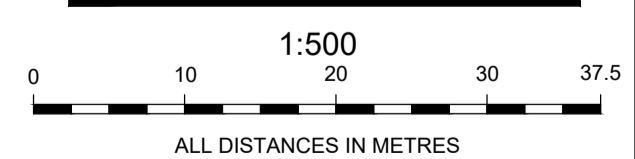

A1	1	5/12/2024	INITIAL ISSUE	MJK	RA	RA
	INDEX	DATE	REVISIONS	DRAWN	CHECKED	PASSED

DRAWN	MJK	5/12/2024
CHECKED	RA	5/12/2024
PASSED	RA	5/12/2024
INITIALS	DATE	

LANDPARTNERS
 surveyors and planners

Sirbane Office
 Level 1
 18 Lisle Cook Street
 Milton QLD 4064

PO Box 1399
 Milton
 QLD 4064

P (07) 3842 1000
 F (07) 3842 1001
 E info@landpartners.com.au
 W www.landpartners.com.au



Queensland Urban Utilities

MONTVIEW ESTATE STAGE 3
 AS-CONSTRUCTED WATER
 22-PNT-55811

SCALE	1:500
SHEET 1	OF 1 SHEETS
DRAWING NO.	BRSS7277-AP3-77-1